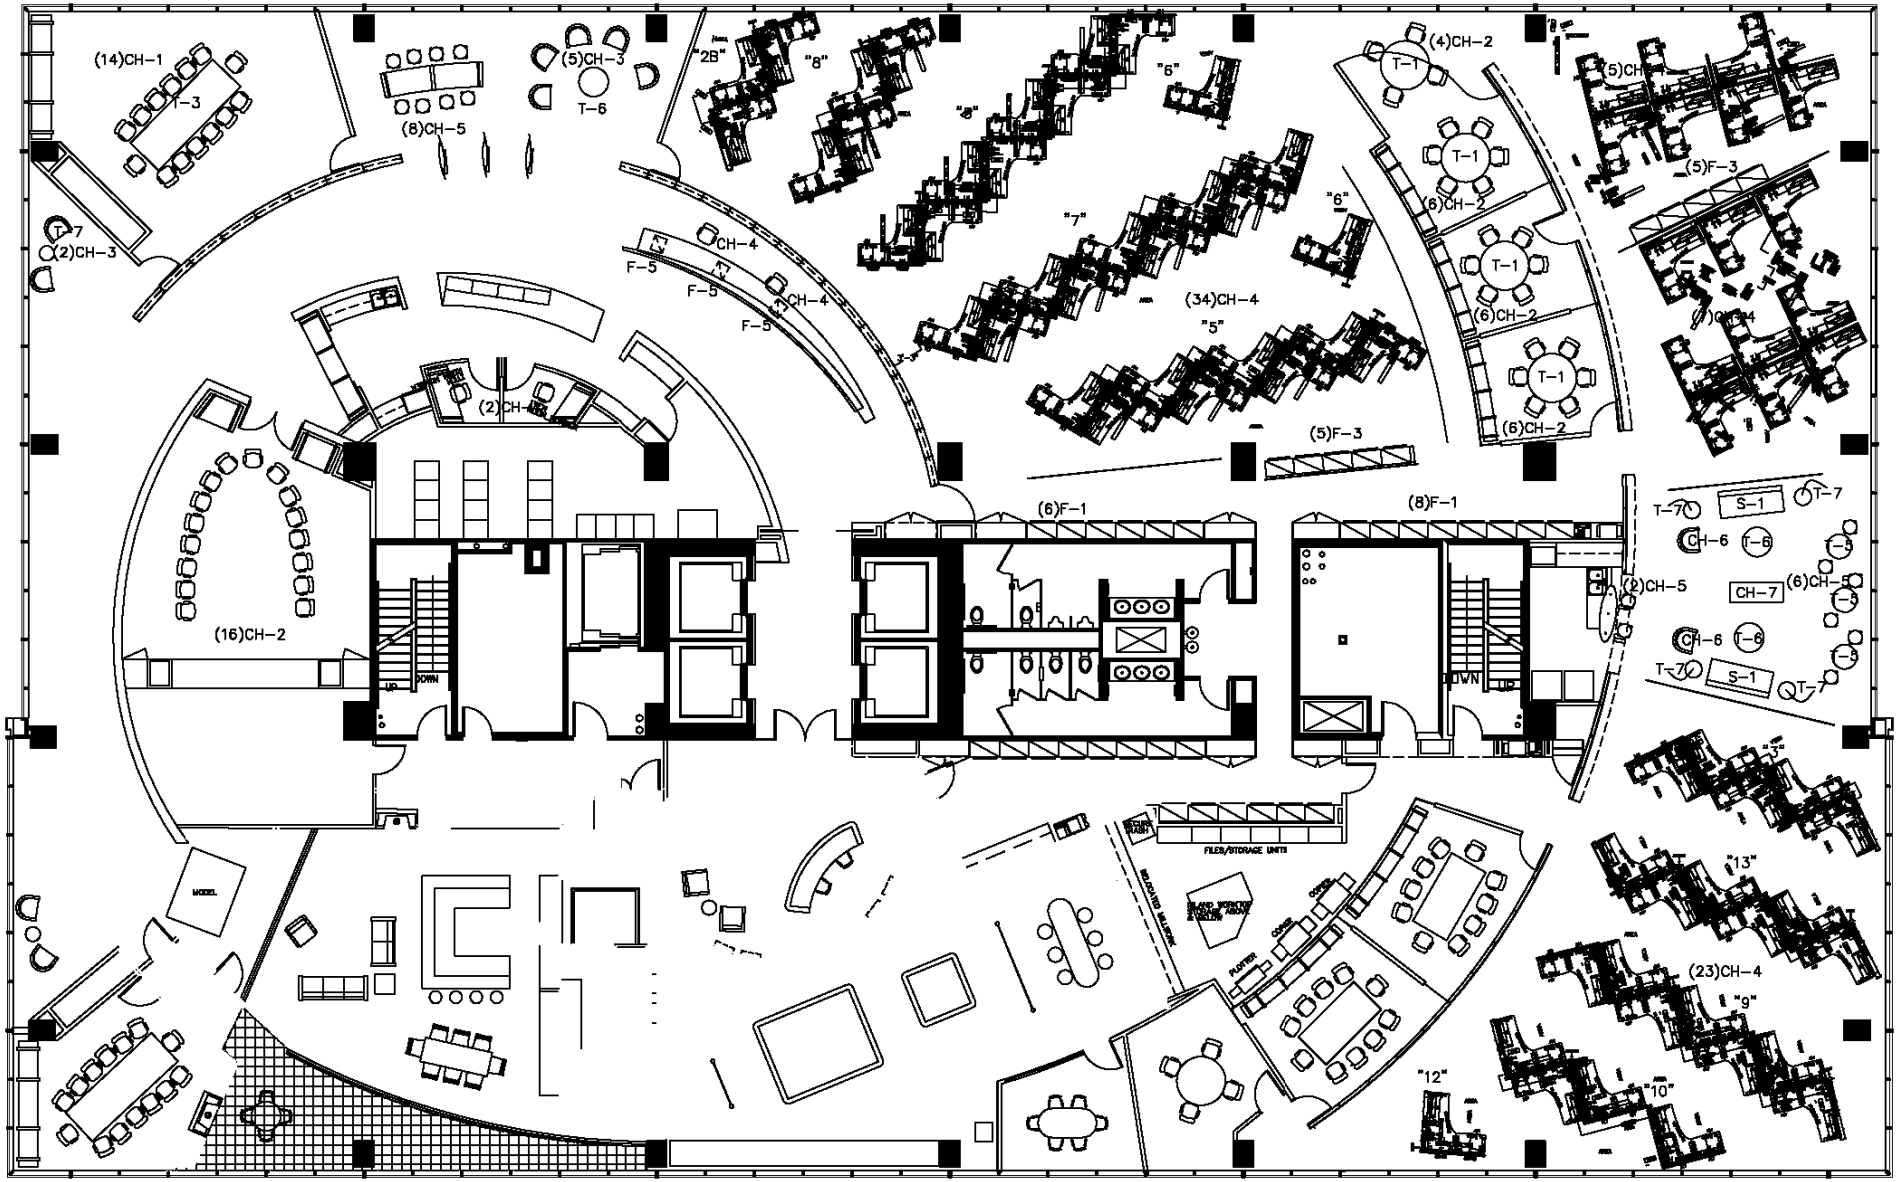

16TH FLOOR

HARWOOD INTERNATIONAL

28|28 NORTH HARWOOD